

ELEVAÇÃO P2/J13

Pianta P2/I13

Technical drawing of a window frame. The frame is divided into four quadrants by a central cross. Each quadrant contains a dashed diagonal line. Dimensions are indicated on the right side: a vertical dimension of 160 and a horizontal dimension of 90, with a total vertical dimension of 250. A label on the left side points to the central cross with the text "Puxador de alumínio".

The drawing consists of two parts: an elevation view on the left and a cross-section view on the right.

ELEVÇÃO (Elevation View): Shows a rectangular door frame with a central panel. The panel is divided into four horizontal sections, numbered 1, 2, 3, and 4 from top to bottom. The frame is numbered 5 on the left and 6 on the right. Dimensions are given in centimeters: a total height of 135 cm, with a top section of 35 cm, a middle section of 65 cm, and a bottom section of 35 cm. A note points to the frame with the text "Tronque-to da La Fonte n° 19 CT".

CORTE B-B (Cross-section View): Shows the door's profile. The top part is labeled "Int." (Interior) and the bottom part "Ext." (Exterior). The total height is 135 cm. The top section has a height of 35 cm and a width of 125 mm. The middle section has a height of 65 cm and a width of 125 mm. The bottom section has a height of 35 cm and a width of 125 mm. The door is shown with a handle and a lock mechanism.

[illegible]

PLANTA P7
Escala: 1:20

Junta de vedação em espuma de borracha ou poliuretano
Corda de alumínio
Al. 1 1/8 x 3/4"
Dobradilha em latão laminada com parafusos (cod. 65) de 3"x3" da "La Fonte" ou similar

DETALHES DA PORTA P7
Escala

A diagram of a horizontal beam of length 200 units, supported at both ends by fixed supports. A triangular load is applied over the entire length of the beam, with its peak at the center. A central point load is also applied at the midpoint of the beam. The word "Exterior" is written above the beam, and the dimension "200" is indicated below the beam.

Rebaixo em gesso

Perfil de alumínio Alcon ou similar de 3,8 x 10,1cm

1125

15

825

90

206

260

120

4

464

Puxador de madeira

Fechadura no piso

ELEVACAO 1

Technical drawing of a door showing elevation and plan views.

Elevation View: The door has a total height of 210 cm. The lower panel is 90 cm high. The width is 70 cm. A label "exterior" points to the left side of the door.

Plan View: The door is shown from above, with a width of 70 cm. A dashed line indicates the "exterior" side.

Labels: "exterior", "70", "90", "210", "PLANTA e ELEVACÃO - 1"


NOTAS

- 1- Todas as atas estão em centímetros, exceto onde indicado.
- 2- Todas as medidas deverão ser confirmados na obra.
- 3- Os cordões de fixação dos vidros serão fixados externamente e aparafusados internamente.
- 4- As portas P1, P2, P6 e P7 terão suas folhas revestidas com lambris de alumínio usados verticalmente

DESENHOS DE REFERÊNCIA

- Casa de Relés - Planta Baixa - 1º Pav. 4529-DC-0300.P
- Casa de Relés - Planta Baixa - 2º Pav. 4529-DC-0301.P
- Casa de Relés - Corte A-A e B-B 4529-DC-0302.P
- Casa de Relés - Corte C-C e D-D 4529-DC-0303.P

LISTA DE MATERIAL N°-----4529-LM-0300-P

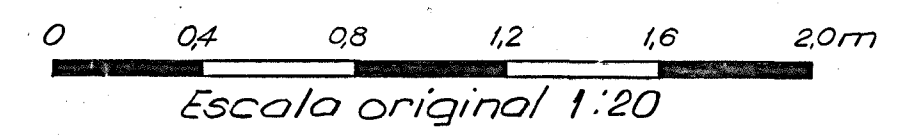

3	Revisado como construído.	21/11/13	21/11/13	21/11/13
2	Modif altura Porta P3 devido rebato de arco de circunferência	21/11/12	21/11/12	23/01/13
1	Modificação quantizada da porta P7	17/11/12	17/11/12	15/01/13
Nº	DESCRIÇÃO	ASSIN	DATA	ASSIN DATA
REVISÕES		IECO - c/c		ITAIPU

PROJ. Reator VERIF. V. M. P. APROV. Adilson L.
DES. Roberto Gonçalves VISTO G. J. M. DATA 22/11/82

IECO - ele
COORDENADOR

BRASIL  ITAIPU  PARAGUAY
BINACIONAL

SUBESTAÇÃO DA MARGEM DIREITA
ARQUITETURA
CASA DE RELÉS
DETALHES - FL.6 - ESQ. PORTAS

ITAIPI BINACIONAL (31) <i>[Signature]</i>	DATA <i>21/01/82</i>	4529-DC-0312-P	R3
--	----------------------	----------------	----

TIPO	DIMENSÕES		QUANT.	MATERIAL		FOLHA	QUANT.
	TARGUJA	AL.TURA		FOLHA	GUARN.		
P1	200	250	2	ALUMÍNIO	ALUMÍNIO	2	1
P2	250	250	3	"	"	2	1
P3	535	260	1	BLINDEX	METÁLICA	2	1
P4	100	210	1	FERRO	FERRO	1	1
P5	80	210	1	"	"	1	1
P6	70	210	1	ALUMÍNIO	ALUMÍNIO	1	1
P7	60	135	2	"	"	1	1